

Scale: 1"=200'

LEGEND

TELEPHONE

====

-₩-**-**

CONTOUR LINE

SPOT ELEVATION

BUILDING


UTILITY POLE HYDRANT


LIGHT FIXTURE

TEST PIT LOCATION

GRADE FLOW ARROW

SWALE CENTER LINE

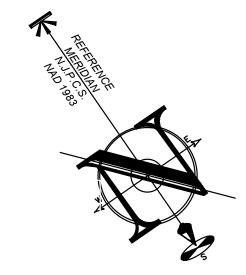

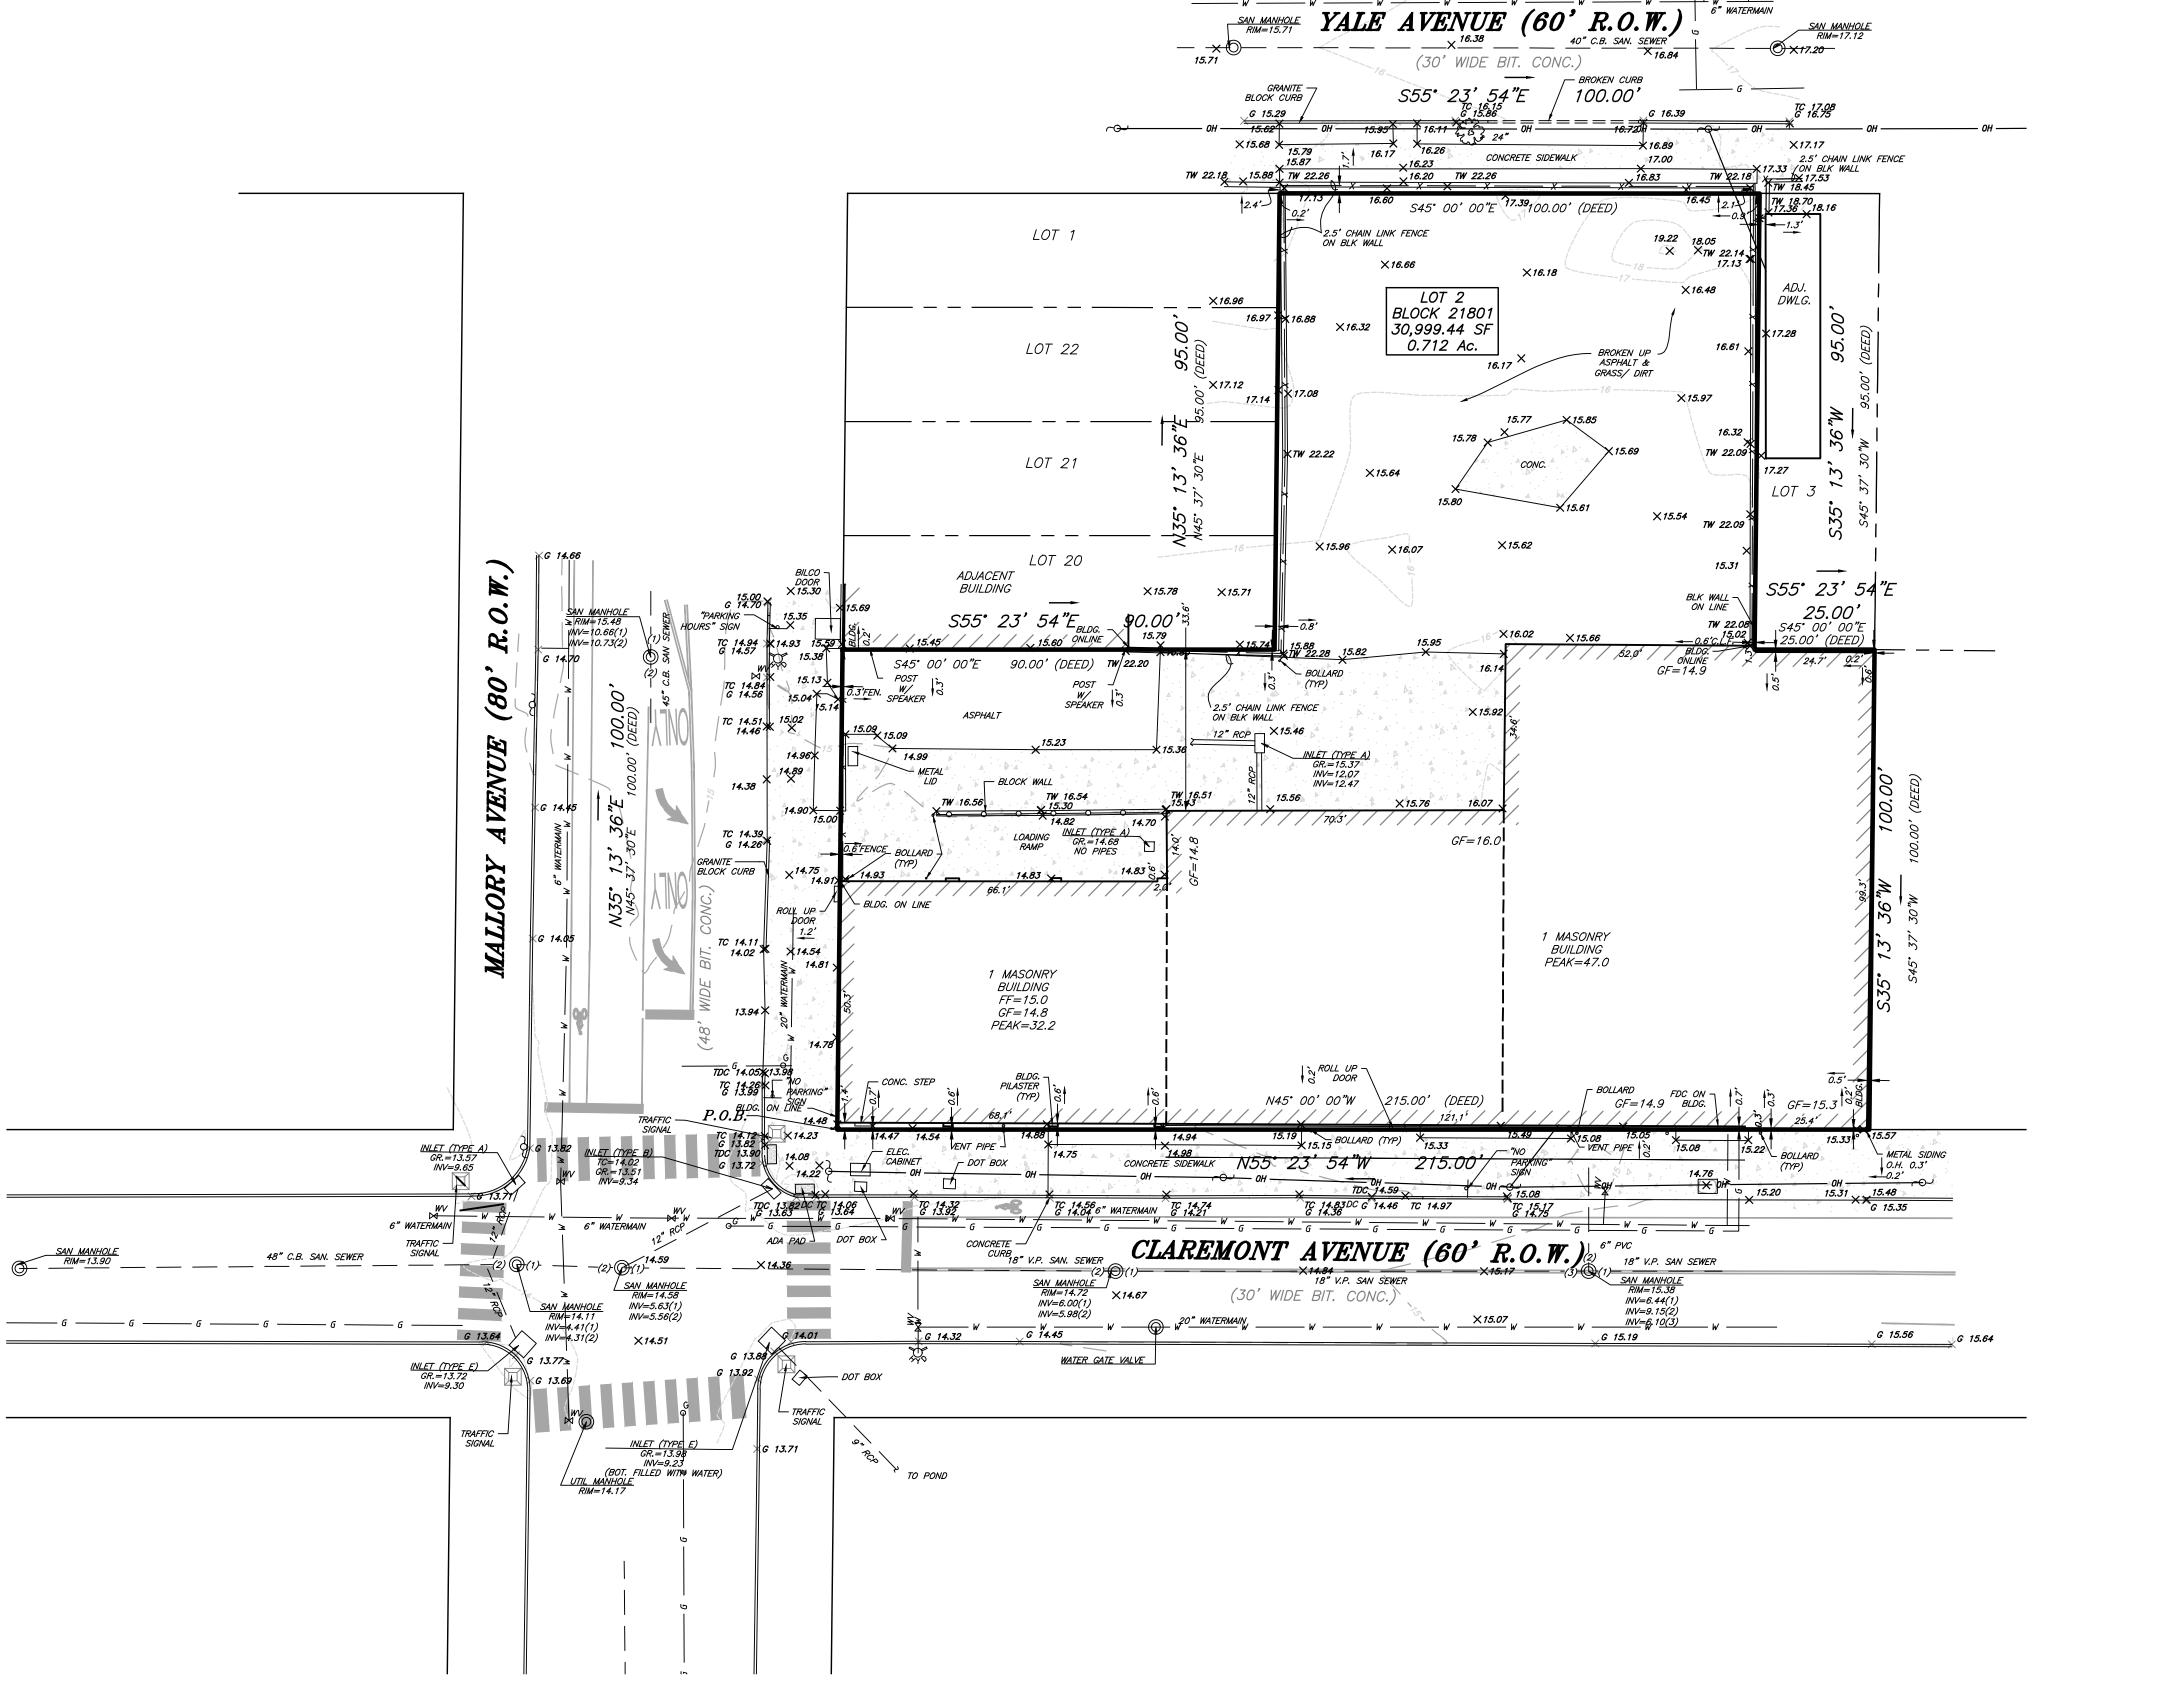

ENCROACHMENT TABLE:

1. BLOCK WALL ON NORTH PROPERTY LINE, ENCROACHES INTO YALE AVENUE RIGHT OF WAY - 2.4'. 2. ROLL UP DOOR ENCROACHES MALLORY. SEE PLAN



TITLE COMMITMENT NO. 600252 SCHEDULE B EXCEPTIONS

SUBJECT TO:

- 1. NOTWITHSTANDING ANY PROVISION OF THE POLICY TO THE CONTRARY, THE FOLLOWING MATTERS ARE EXPRESSLY EXCEPTED FROM THE COVERAGE OF THE POLICY, AND THE COMPANY WILL NOT PAY LOSS OR DAMAGE, COSTS, ATTORNEY'S FEES, OR EXPENSES THAT ARISE BY REASON OF ANY ENCROACHMENT, ENCUMBRANCE, VIOLATION, VARIATION, OR ADVERSE CIRCUMSTANCE AFFECTING THE TITLE THAT WOULD BE DISCLOSED BY AN ACCURATE AND COMPLETE LAND SURVEY OF THE
- 2. RIGHTS OR CLAIMS BY PARTIES IN POSSESSION OF THE LAND NOT SHOWN BY THE PUBLIC RECORD. 3. EASEMENTS, OR CLAIMS OF EASEMENTS, NOT SHOWN BY THE PUBLIC RECORDS.
- 4. ANY LIENS OR INTERESTS ARISING BETWEEN THE DATE OF THIS COMMITMENT AND THE DATE ON WHICH THE DOCUMENTS CREATING THE INTEREST TO BE INSURED ARE RECORDED AND INDEXED IN
- SUBSURFACE CONDITIONS AND/OR ENCROACHMENTS NOT DISCLOSED BY AN INSTRUMENT OF
- 6. (SCHEDULE B-12) UNRECORDED EASEMENT AGREEMENT DATED 3/25/1935 MADE TO CENTRAL RAILROAD COMPANY OF NEW JERSEY.
- NOTE: RECITED IN DEED BOOK 3083 PAGE 166. (OFFSITE NOT PLOTTED)
- 7. (SCHEDULE B-13) UNRECORDED EASEMENT AGREEMENT DATED 9/30/1893 MADE BY AND BETWEEN CENTRAL RAILROAD COMPANY OF NEW JERSEY AND TRINIDAD BITUMINOUS ASPHALT COMPANY. NOTE: RECITED IN DEED BOOK 1222 PAGE 648. (OFFSITE NOT PLOTTED)
- 8. (SCHEDULE B-14) ENCROACHMENT AGREEMENT SET FORTH IN DEED MADE BY THE CULVER CORPORATION TO KERLOW STEEL FLOORING CO., DATED 9/30/1936 AND RECORDED 10/1/1936 IN DEED BOOK 1883 PAGE 481. (OFFSITE NOT PLOTTED)
- 9. (SCHEDULE B-15) PARTY WALL RECITAL CONTAINED IN DEED MADE BY KERLOW STEEL FLOORING CO. TO CULVER REALTY COMPANY, DATED 5/24/1948 AND RECORDED 6/9/1948 IN DEED BOOK 2312 PAGE 169. (OFFSITE NOT PLOTTED)
- 10. (SCHEDULE B-16) RIGHTS, PUBLIC AND PRIVATE, IN AND TO SO MUCH OF THE LAND AS LIES WITHIN THE BED OF POLLACK AVENUE AS A RESULT OF ORDINANCE VACATING A PORTION OF POLLOCK AVENUE RECORDED 2/14/1969 IN STREET VACATION BOOK 4 PAGE 197, AS APPROXIMATELY SHOWN ON A SURVEY BY INSITE SURVEYING DATED 5/21/2020, JUSTIN L. HEDGES PLS. (OFFSITE NOT
- 11. (SCHEDULE B-17) RIGHTS AND EASEMENTS CONTAINED IN DEED MADE BY CULVER REALTY COMPANY TO BRIGHT STEEL CORPORATION, DATED 7/24/1970 AND RECORDED 8/5/1970 IN DEED BOOK 3083 PAGE 166. (OFFSITE NOT PLOTTED)

SURVEY NOTES:

- . <u>PROPERTY DESIGNATION</u>: PROPERTY KNOWN AND DESIGNATED AS TAX LOT 2, BLOCK 21801, AS SHOWN ON THE OFFICIAL TAX MAP OF THE CITY OF JERSEY CITY, HUDSON COUNTY, NEW JERSEY, TAX MAP SHEET 218.
- **2. PROPERTY AREA**: 30,999 S.F. OR 0.712 ACRES.

RECORD. (FEE POLICY ONLY)

- 3. BUILDING FOOTPRINT AREA: 15,660 S.F.
- 4. <u>CERTIFICATION</u>: THIS IS TO CERTIFY THAT THIS SURVEY IS ACCURATE, AND THAT THIS DRAWING IS TRUE REPRESENTATION OF ACTUAL CONDITIONS EXISTING ON THE PROPERTY, EXCEPT SUCH EASEMENTS, IF ANY, THAT MAY BE LOCATED BELOW THE SURFACE OF THE LANDS, OR ON THE SURFACE OF THE LANDS AND NOT VISIBLE.
- 5. CORNER MARKERS: CORNER MARKERS SHALL BE FOUND OR SET.
- 6. <u>TITLE REPORT</u>: COMMITMENT NO. 600252 AND IS SUBJECT TO ANY EASEMENTS AND RESTRICTIONS CONTAINED THEREIN.
- 7. <u>WETLANDS</u>: NO WETLANDS ARE KNOWN TO EXIST AT THE SITE.
- 8. <u>FEMA</u>: SUBJECT PROPERTY IS LOCATED IN EFFECTIVE FEMA FLOOD ZONE X ELEVATION N/A/ PER FLOOD HAZARD DATA , PANEL NO. 34017C0104D DATED 8/16/2006.SUBJECT PROPERTY IS LOCATED IN PRELIMINARY FLOOD ZONE X ELEVATION N/A & AE ELEVATION 10 PER FLOOD HAZARD MAP DATA, PANEL NO. 34017C0104E, DATED 1/30/15.
- 9. <u>TIDELANDS</u>: A TIDELANDS SEARCH SHOWS NO PORTION OF THE PROPERTY IS CLAIMED BY THE STATE OF NEW JERSEY.
- 10. <u>HORIZONTAL DATUM</u>: THE BEARINGS AND DISTANCES SHOWN HEREON REFERENCE THE NEW
- JERSEY STATE PLANE COORDINATE SYSTEM (N.J.P.C.S.) NORTH AMERICAN DATUM OF 1983 (NAD 83). 11. <u>VERTICAL DATUM</u>: ALL ELEVATIONS ARE RELATIVE TO THE NORTH AMERICAN DATUM OF 1988 (NAVD88). BENCHMARK UTILIZED-DESIGNATION R16, PIDKV0294, ELEV. -1.00.
- 12. <u>UTILITIES</u>: LOCATION OF ALL UNDERGROUND UTILITIES ARE APPROXIMATE. ALL LOCATIONS AND ES ARE BASED ON PRIOR UTILITY MARK-OUTS, ABOVE GROUND STRUCTURES THAT WERE VISIBLE & ACCESSIBLE IN THE FIELD, AND THE MAPS AS LISTED IN THE REFERENCES AVAILABLE AT THE TIME OF THE SURVEY. AVAILABLE AS-BUILT PLANS AND UTILITY MARKOUT DOES NOT ENSURE MAPPING OF ALL UNDERGROUND UTILITIES AND STRUCTURES. BEFORE ANY EXCAVATION IS TO BEGIN, ALL UNDERGROUND UTILITIES SHOULD BE VERIFIED AS TO THEIR LOCATION, SIZE AND TYPE BY THE PROPER UTILITY COMPANY. THE LOCATION AND EXTENT OF UNDERGROUND VAULTS AND
- 13. <u>STATE CERTIFICATION:</u> TO THE BEST OF MY KNOWLEDGE AND BELIEF, THIS SURVEY WAS PERFORMED IN ACCORDANCE WITH THE RULES SET FORTH IN N.J.A.C. 13:40-5 (PREPARATION OF LAND SURVEYS) AND WAS CONDUCTED UNDER MY DIRECT SUPERVISION IN ACCORDANCE WITH
- 14. ERROR OF CLOSURE: THE ERROR OF CLOSURE HAS BEEN CALCULATED TO BE 1:4,100,030.00
- 15. PARKING: PARKING SPACES NOT MARKED.
- **16.** <u>EARTH MOVING/BUILDING CONSTRUCTION:</u> NO EVIDENCE OF RECENT EARTH MOVING, BUILDING CONSTRUCTION OR BUILDING ADDITIONS WAS OBSERVED. 13. <u>CEMETERIES</u>: NO EVIDENCE OF A CEMETERY WAS FOUND
- 14. RIGHT OF WAY: NO EVIDENCE OF RIGHT OF WAY CHANGES WAS FOUND.
- 15. <u>LANDFILL:</u> NO EVIDENCE OF A LANDFILL WAS FOUND.

TANKS HAVE NOT BEEN VERIFIED BY THE SURVEYOR.

N.J.A.C. 13:40-9.

RECORD DESCRIPTION OF PROPERTY

PARCEL A TAX LOT 2 BLOCK 21801 CITY OF JERSEY CITY HUDSON COUNTY **NEW JERSEY**

- ALL THAT CERTAIN PLOT, PIECE OR PARCEL OF LAND, SITUATE, LYING AND BEING IN THE CITY OF JERSEY CITY, COUNTY OF HUDSON AND STATE OF NEW JERSEY. THE LEGAL DESCRIPTION IS: BEGINNING AT THE POINT OF INTERSECTION OF THE NORTHEASTERLY LINE OF CLAREMONT AVENUE WITH
- THE SOUTHEASTERLY LINE OF MALLORY AVENUE; RUNNING THENCE
- 1. ALONG SAID SOUTHEASTERLY LINE OF MALLORY AVENUE, NORTH 45 DEGREES 37 MINUTES 30 SECONDS EAST, 100.00 FEET TO A POINT; THENCE
- 2. SOUTH 45 DEGREES EAST, 90.00 FEET TO A POINT; THENCE
- 3. NORTH 45 DEGREES 37 MINUTES 30 SECONDS EAST, 95.00 FEET TO A POINT IN THE SOUTHWESTERLY LINE OF YALE AVENUE; THENCE
- 4. ALONG SAID SOUTHWESTERLY LINE OF YALE AVENUE, SOUTH 45 DEGREES EAST, 100.00 FEET TO A POINT; THENCE
- 5. SOUTH 45 DEGREES 37 MINUTES 30 SECONDS WEST, 95.00 FEET TO A POINT; THENCE 6. SOUTH 45 DEGREES EAST, 25.00 FEET TO A POINT; THENCE
- 7. SOUTH 45 DEGREES 37 MINUTES 30 SECONDS WEST, 100.00 FEET TO A POINT IN SAID NORTHEASTERLY LINE OF CLAREMONT AVENUE; THENCE
- 8. ALONG SAID NORTHEASTERLY LINE OF CLAREMONT AVENUE, NORTH 45 DEGREES WEST, 215.00 FEET TO THE POINT OR PLACE OF **BEGINNING**.

DESCRIPTION OF PROPERTY AS SURVEYED

NEW JERSEY

TAX LOT 2 BLOCK 21801 CITY OF JERSEY CITY **HUDSON COUNTY**

ALL THAT CERTAIN LOT, TRACT OR PARCEL OF LAND, SITUATE IN THE CITY OF JERSEY CITY, HUDSON COUNTY, NEW JERSEY, BEING KNOWN AS TAX LOT 2, BLOCK 21801 AS SHOWN ON THE TAX MAP OF THE CITY OF JERSEY CITY AND BEING MORE PARTICULARLY DESCRIBED AS FOLLOWS:

BEGINNING AT THE POINT OF INTERSECTION OF THE NORTHEASTERLY LINE OF CLAREMONT AVENUE WITH THE SOUTHEASTERLY LINE OF MALLORY AVENUE; RUNNING THENCE 1. ALONG SAID SOUTHEASTERLY LINE OF MALLORY AVENUE, NORTH 35 DEGREES 13 MINUTES 36

- SECONDS EAST, 100.00 FEET TO A POINT; THENCE 2. SOUTH 55 DEGREES 23 MINUTES 54 SECONDS EAST, 90.00 FEET TO A POINT; THENCE
- 3. NORTH 35 DEGREES 13 MINUTES 36 SECONDS EAST, 95.00 FEET TO A POINT IN THE SOUTHWESTERLY
- LINE OF YALE AVENUE; THENCE 4. ALONG SAID SOUTHWESTERLY LINE OF YALE AVENUE, SOUTH 55 DEGREES 23 MINUTES 54 SECONDS
- EAST, 100.00 FEET TO A POINT; THENCE
- 5. SOUTH 35 DEGREES 13 MINUTES 36 SECONDS WEST, 95.00 FEET TO A POINT; THENCE 6. SOUTH 55 DEGREES 23 MINUTES 54 SECONDS EAST, 25.00 FEET TO A POINT; THENCE

7. SOUTH 35 DEGREES 13 MINUTES 36 SECONDS WEST, 100.00 FEET TO A POINT IN SAID

- NORTHEASTERLY LINE OF CLAREMONT AVENUE; THENCE 8. ALONG SAID NORTHEASTERLY LINE OF CLAREMONT AVENUE, NORTH 55 DEGREES 23 MINUTES 54
- SECONDS WEST, 215.00 FEET TO THE POINT AND PLACE OF **BEGINNING**.

ENCROACHMENTS:

- 1. BLOCK WALL AND CHAIN LINK FENCE ON NORTH PROPERTY LINE ENCROACHES YALE AVENUE
- RIGHT OF WAY- 2.4'.
- 2. SPEAKERS ON BUILDING LOT 20 ENCROACH 0.3'. 3. ROLL UP DOOR AND METAL OVERHANG ENCROACH CLAREMONT AVENUE - SEE PLAN.

ALTA/NSPS

LAND TITLE SURVEY BLOCK 21801, LOT 2 70 MALLORY AVENUE

SITUATED IN:

CITY OF JERSEY CITY **HUDSON COUNTY** NEW JERSEY

REPARED FOR:

DHA CAPITAL, LLC

NJ ONE CALL....800-272-1000

InSite Surveying, LLC CERTIFICATE OF AUTHORIZATION: 24GA28290100 1955 ROUTE 34, SUITE 1A, WALL, NJ 07719

732-531-7100 (Ph) 732-531-7344 (Fax)

InSite@InsiteSurveying.net

www.InSiteSurveying.net

REVISIONS

8/11/21 REVISE PER ENGINEERS COMMENTS

2/12/21 REVISE PER UPDATED TITLE REPORT 1/28/21 REVISE PER TITLE COMMENTS 8/12/20 REVISE PER TITLE COMPANY 7/22/20 REVISE PER TITLE COMPANY 6/5/20 INITIAL RELEASE DRAWN BY: BLG SCALE: 1"=20'

DATE: 6/3/20 CHECKED BY: **JJH** JOB#: 20-S300-01

CERTIFICATION WHICH IT IS BASED WERE MADE IN ACCORDANCE WITH THE 2016 MINIMUM STANDARDS DETAIL REQUIREMENTS FOR ALTA/NSPS LAND TILE SURVEYS, JOINTLY ESTABLISHED AND ADOPTED BY ALTA AN

NSPS, AND INCLUDES ITEMS 1, 2, 3, 4, 5, 7a, b, c, 8, 11, 13 & 16 OF TABLE A THEREOF. THE FIELDWORK WAS COMPLETED ON 5/21/20. CERTIFIED TO:

70 MALLORY, LLC STEWART TITLE GUARANTEE COMPANY ROYAL ABSTRACT OF NEW JERSEY LLC

CAUTION: IF THIS DOCUMENT DOES NOT CONTAIN THE SIGNATURE

PROFESSIONAL LAND SURVEYOR NJ LIC. NO. GS43362