


### FHA LINE DATA

| SEGMENT | DIRECTION       | LENGTH |
|---------|-----------------|--------|
| FL-1    | N 10° 21' 55" W | 208.79 |
| FL-2    | N 23° 33' 22" W | 42.31  |
| FL-3    | N 29° 01' 11" W | 68.61  |
| FL-4    | N 1° 12' 14" E  | 20.83  |
| FL-5    | N 23° 50' 00" E | 221.39 |
| FL-6    | N 77° 59' 22" E | 8.46   |
| FL-7    | S 62° 40' 05" E | 31.54  |
| FL-8    | S 21° 01' 02" E | 6.53   |
| FL-9    | S 15° 39' 24" W | 16.28  |
| FL-10   | S 32° 27' 12" E | 8.36   |
| FL-11   | S 24° 29' 05" W | 60.02  |

### FHA LINE DATA

| SEGMENT | DIRECTION       | LENGTH |
|---------|-----------------|--------|
| FL-12   | S 24° 46' 41" E | 13.80  |
| FL-13   | N 42° 40' 14" E | 38.43  |
| FL-14   | S 07° 37' 34" E | 28.29  |
| FL-15   | N 25° 07' 21" E | 44.28  |
| FL-16   | N 40° 44' 57" E | 14.33  |
| FL-17   | N 86° 16' 13" E | 22.85  |
| FL-18   | N 34° 41' 24" E | 1.00   |
| FL-19   | S 55° 18' 31" E | 46.29  |
| FL-20   | S 55° 18' 31" E | 41.91  |
| FL-21   | S 55° 18' 31" E | 74.15  |
| FL-22   | N 55° 18' 35" W | 227.40 |

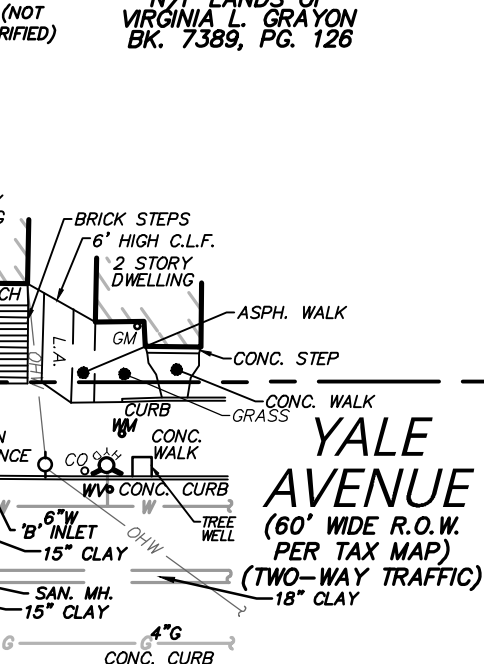

### INFORMATION OF FACT

| NO. | DESCRIPTION         | YES | NO | ITEM  |
|-----|---------------------|-----|----|---|
| 1.  | DEED OF RECORD      | X   |    | BK 9556, PG. 12   |
| 2.  | FILED MAP           | X   |    | MAP #268, FILED 6-12-1873 W/ HUDSON COUNTY MAP #578, FILED 5-16-1867 W/ HUDSON COUNTY MAP #20181913000170 FILED 10/19/2018 W/ HUDSON COUNTY   |
| 3.  | TITLE SEARCH/BINDER | X   |    | TRIDENT ABSTRACT TITLE AGENCY, LLC (ISSUING AGENT) FIDELITY NATIONAL TITLE INSURANCE COMPANY FILE NUMBER TA 145347-1; COMMITMENT DATE: OCTOBER 15, 2019 FILE NUMBER TA 155555; COMMITMENT DATE: MARCH 9, 2022 |
| 4.  | TAX MAP             | X   |    | SHEET 207   |
| 5.  | OTHER (SEE REF)     | X   |    | SEE NOTE 3  |

### MAP & DOCUMENT REFERENCES

- MAP ENTITLED "MAP OF BUILDING LOTS ON THE LINE OF THE NEWARK & NEW YORK R.R. 20 MINUTES FROM NEW YORK AT WEST BERGEN HUDSON CO. N.J." FILED ON MAY 16, 1867 AS MAP # 578 WITH HUDSON COUNTY.
- MAP ENTITLED "A MAP OF LOTS IN THE SIXTEENTH WARD, JERSEY CITY, BELONGING TO W. CLARKE AND H. N. EGAN 1873"; FILED ON JUNE 12, 1873 AS MAP # 268 WITH HUDSON COUNTY, SHEETS 1 & 2 OF 2.
- MAP ENTITLED "MAJOR SUBDIVISION PLAN FOR 100 WATER STREET, LLC, PROPOSED LOTS A, B, & C, BLOCK 20703, LOTS 2.1, 2.2, CITY OF JERSEY CITY, HUDSON COUNTY, NEW JERSEY"; PREPARED BY MASER CONSULTING, P.A., DATED: JUNE 15, 2017 AND REVISED THROUGH AUGUST 2, 2018.
- MAP ENTITLED "UTILITY AS-BUILT SURVEY FOR BLOCK 20703, LOTS 2.01 & 3.01, BLOCK 20704, LOT 1 & 2, #132, 135, & 165 VALE AVENUE, CITY OF JERSEY CITY, HUDSON COUNTY, NEW JERSEY"; PREPARED BY MASER CONSULTING, P.A., DATED: MARCH 17, 2020 AND REVISED THROUGH JUNE 17, 2020.
- MAP ENTITLED "AS BUILT DRAWING PLUMBING UNDER GROUND FLOOR PLAN, 100 WATER STREET, BUILDING '11', PREPARED BY HAZZAD PLUMBING & HEATING, DATED APRIL 20, 2021.
- MAP ENTITLED "AMENDED FINAL MAJOR SITE PLAN (SITE 1.1 & 1.2) FOR 100 WATER STREET DEVELOPMENT, LLC, BLOCK 20703, LOTS 2.01 & 3.01, BLOCK 20704, LOTS 1 & 2 (FORMERLY KNOWN AS BLOCK 20703, LOTS 2.1, 2.2, 3.1, 3.2, 3.3, 160.5,